


HEATING WATER CONTROL LEGEND		
DESIGNATION	DESCRIPTION	FUNCTION
PT	STEAM PRESSURE TRANSMITTER	SENSES AND TRANSMITS STEAM PRESSURE TO DCP
TS-1	WATER TEMPERATURE SENSOR W/STAINLESS STEEL WELL	SENSES AND TRANSMITS HOT WATER TEMPERATURE TO DCP
V-1, V-2	2 POSITION HOT WATER VALVE	ISOLATES INACTIVE CONVERTER
V-3, V-4	MODULATING CONTROL STEAM VALVE	REGULATES STEAM FLOW TO CONVERTER
V-5, V-6	FLOATING CONTROL STEAM VALVE	CHANGES STEAM FLOW TO CONVERTER WHEN "V-3, V-4" IS EITHER FULL OPEN OR CLOSED (VERNIER CONTROL)

RESET SCHEDULE	
O/A TEMP °F	WATER TEMP °F
30	180
40	180
50	170
60	160
70	150
80	140
90	140

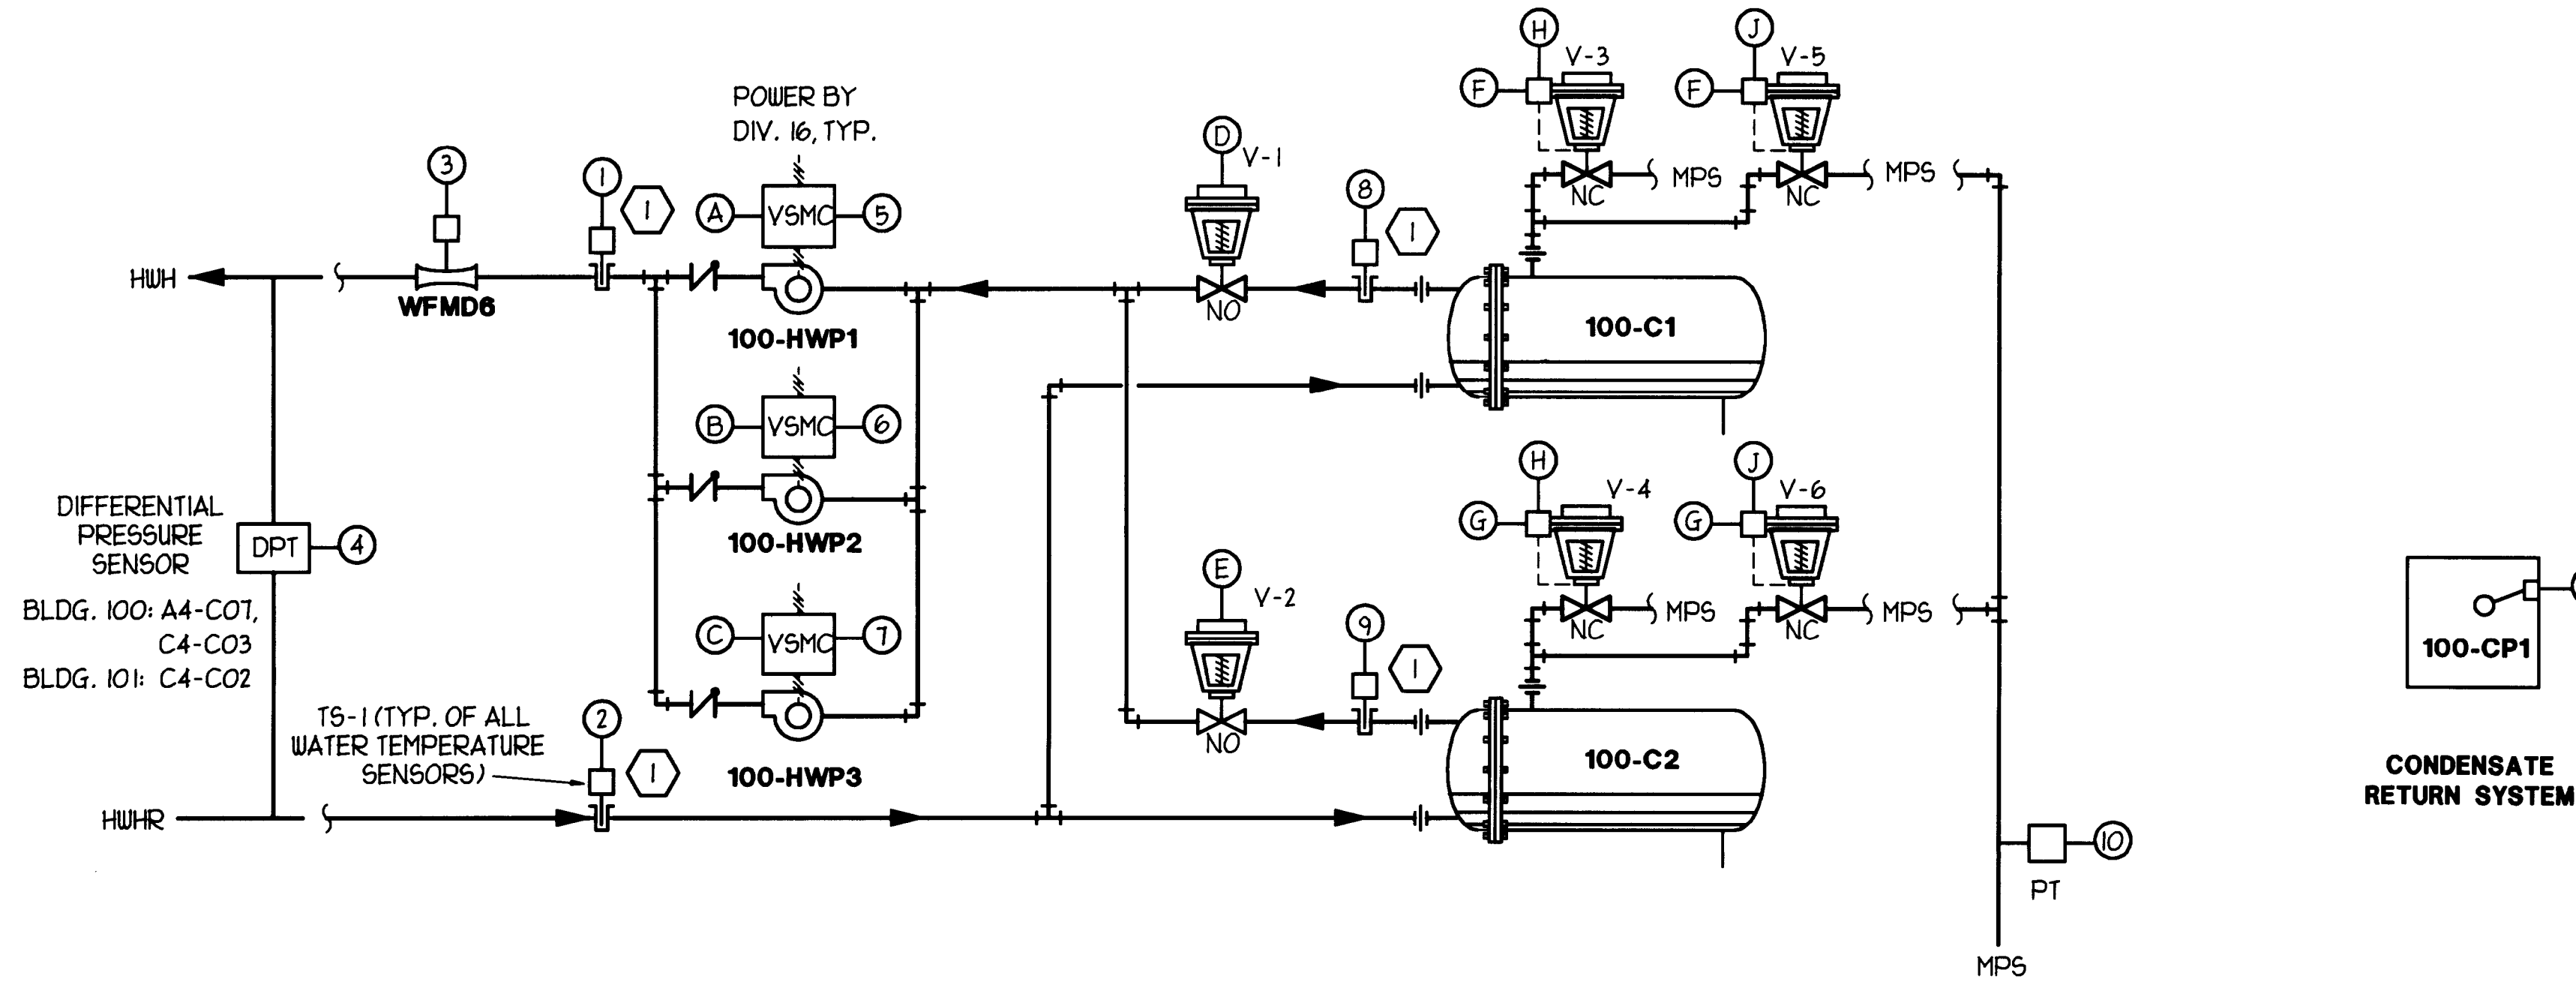

HOT WATER HEATING SYSTEM TEMPERATURE CONTROL & FLOW DIAGRAM


ENGINEERING CONTROL CENTER (ECC) INPUT/OUTPUT SCHEDULE																							
	QUANTITY REQUIRED	GENERAL	HARDWARE														SOFTWARE						REMARKS
			OUTPUTS		INPUT				ALARMS		APPLICATION PROGRAMS												
			DIGITAL	ANALOG	DIGITAL	ANALOG	DIGITAL	ANALOG	DIGITAL	ANALOG	DIGITAL	ANALOG	DIGITAL	ANALOG	DIGITAL	ANALOG	DIGITAL	ANALOG					
HEATING WATER SYSTEM	1	X																					
HWP-1, HWP-2 & HWP-3 (VSMC)	3				X																	PUMPS ENABLED THRU. ANALOG INPUTS	
HUWH	1																						
HUHR	1																						
HUWH PRESSURE SENSOR (DPT)	2																						
MODULATING (VERNIER) STEAM VALVES	2		X	X		X																V-3, V-4	
FLOATING STEAM VALVES	2																					V-5, V-6	
CONVERTER HUWH	2																						
CONVERTER STEAM SUPPLY	1		X																			D.O. ENABLES CONVERTER STEAM VALVES	
DDC EMERGENCY BYPASS	1																						
CONDENSATE RETURN PUMPS	2						X	X															

DIAGRAM NOTE:

- REFER TO SHEET H5.1.1 THRU H5.1.3 FOR "ECC" INPUT/OUTPUT SCHEDULE.
- FOR WET SIDE CONTROL LEGEND (TYPICAL) SEE H5.3.1

SHEET NOTE:

- TEMPERATURE SENSORS ① & ② SHALL BE CALIBRATED MATCHED PAIRS.

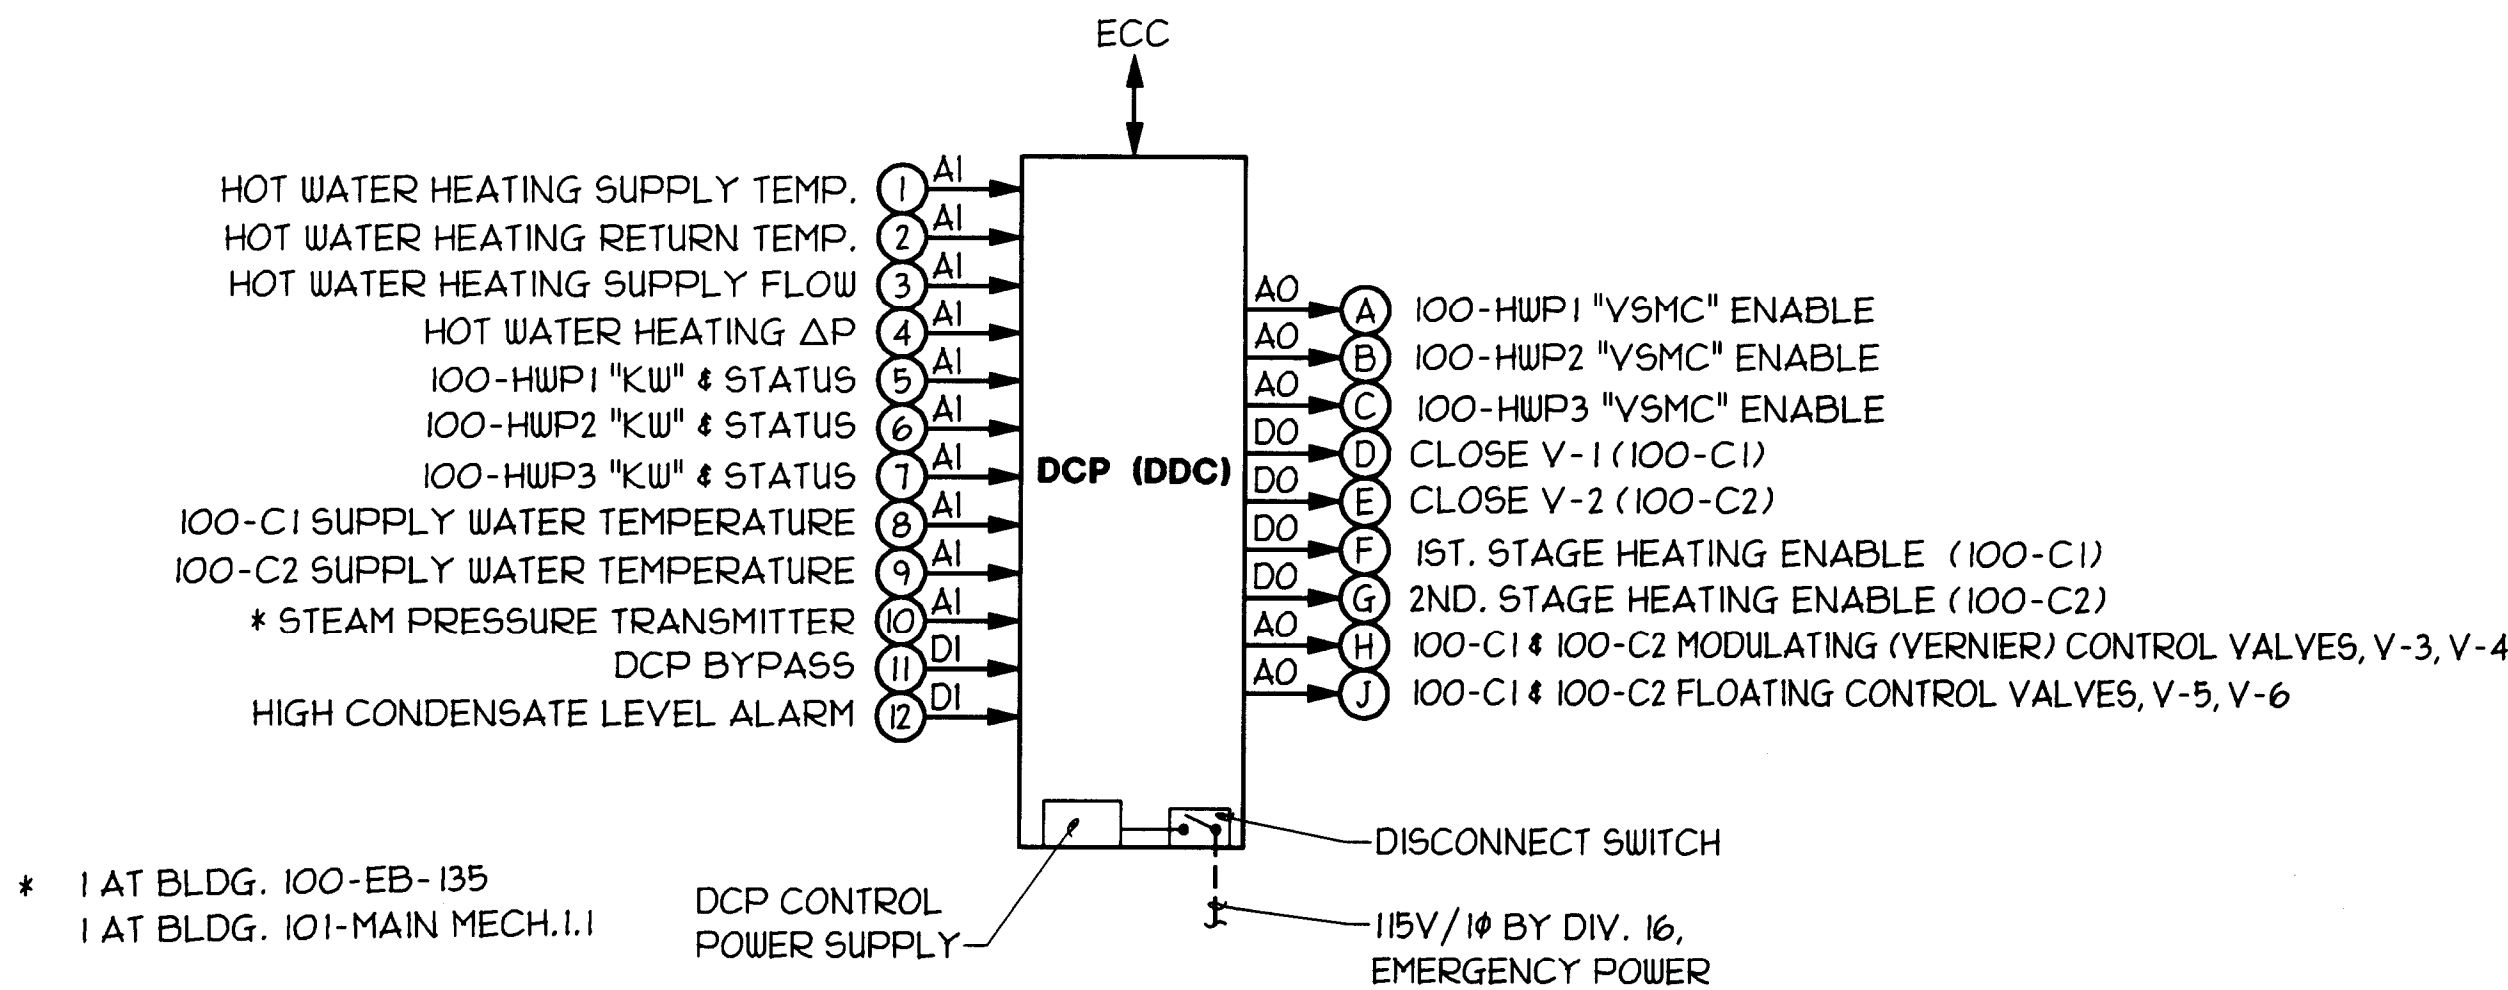

DCP POINT CONFIGURATION

## HOT WATER HEATING HEATING SEQUENCE OF OPERATION

### HOT WATER HEATING PUMPS

THE HOT WATER HEATING SYSTEM IS SERVED BY THREE HOT WATER HEATING PUMPS (100-HWP1, 100-HWP2 & 100-HWP3) EQUIPPED WITH VARIABLE SPEED MOTOR CONTROLLERS (VSMC). TWO PUMPS ARE REQUIRED TO MEET THE HOT WATER REQUIREMENTS AND THE THIRD PUMP IS TO BE UTILIZED AS A STAND-BY. THE "LEAD" PUMP SHALL OPERATE CONTINUOUSLY. THE "ECC", VIA THE DCP, SHALL MONITOR THE HOT WATER LOOP DIFFERENTIAL PRESSURE TRANSMITTER AND CONTROL PUMP SPEED AS REQUIRED TO MAINTAIN A DIFFERENTIAL PRESSURE TO BE DETERMINED DURING TESTING & BALANCING AT THE TRANSMITTER WITH THE LOWEST DIFFERENTIAL PRESSURE.

IF THE DIFFERENTIAL PRESSURE SET POINT CANNOT BE MAINTAINED BY ONE PUMP FOR A CONTINUOUS 5 MINUTE PERIOD, THE "ECC", VIA THE DCP, SHALL ENABLE THE SECOND PUMP IN THE "LEAD-LAG" SEQUENCE AND THE SPEED OF BOTH PUMPS SHALL BE EQUALIZED AND CONTROLLED IN PARALLEL TO MAINTAIN SETPOINT. IF THE WATER FLOW (MEASURED THROUGH FLOW METER "WFMD6") IS LESS THAN WHAT ONE PUMP CAN PRODUCE AT 100% SPEED FOR A CONTINUOUS 5 MINUTE PERIOD THE "LAG" PUMP SHALL BE DE-ENERGIZED.

IF AN ENABLED PUMP'S OPERATION IS NOT CONFIRMED BY ITS RESPECTIVE "VSMC'S" KW OUTPUT SIGNAL AND OR THE HOT WATER HEATING FLOW METER (WFMD6), A PUMP FAILURE ALARM SHALL BE REPORTED TO THE "ECC", VIA THE DCP, AND THE NEXT PUMP IN THE LEAD-LAG SEQUENCE SHALL BE ENABLED IF NOT ALREADY OPERATING.

ONCE A MONTH, THE "ECC" SHALL SELECT THE PUMP WITH THE FEWEST TOTAL OPERATING HOURS TO BE THE "LEAD" PUMP IN THE "LEAD-LAG" SEQUENCE.

### HOT WATER HEATING SYSTEM CONTROL

THE SYSTEM IS SERVED BY TWO STEAM TO HOT WATER CONVERTERS (100-C1 & 100-C2). BOTH CONVERTERS ARE NEEDED TO MEET HEATING DEMAND. EACH CONVERTER HAS A WATER ISOLATION VALVE (V-1 OR V-2) WHICH SHALL CLOSE WHEN THE CONVERTER IS NOT OPERATIONAL. EACH CONVERTER SHALL BE EQUIPPED WITH TWO STEAM CONTROL VALVES (V-3 OR V-4 & V-5 OR V-6).

WHEN ONE PUMP IS OPERATIONAL, THE "LAG" CONVERTER ISOLATION VALVE (V-2 OR V-1) SHALL BE CLOSED AND THE "LEAD" CONVERTER'S VERNIER STEAM FLOW CONTROL VALVE (V-3 OR V-4) SHALL BE ENABLED FOR AUTOMATIC CONTROL. WHEN THERE IS A SECOND STAGE HEATING DEMAND (TWO HOT WATER PUMPS ARE OPERATIONAL) THE "LAG" CONVERTER'S ISOLATION VALVE (V-2 OR V-1) SHALL BE OPENED AND ITS VERNIER STEAM FLOW CONTROL VALVE (V-4 OR V-3) SHALL BE ENABLED TO OPERATE IN PARALLEL WITH THE "LEAD" CONVERTER'S CONTROL VALVE (V-3 OR V-4).

### VERNIER CONTROL

ON A HEATING DEMAND, FIRST THE SMALL STEAM FLOW CONTROL VALVE (V-3 OR V-4) (VERNIER STEAM FLOW CAPACITY) SHALL MODULATE TO MAINTAIN HOT WATER SUPPLY TEMPERATURE SET POINT. IF THE VALVE (V-3 OR V-4) REACHES THE 100% OPEN POSITION, LARGE STEAM VALVE (V-5 OR V-6) (2/3 STEAM FLOW CAPACITY) SHALL SLOWLY POSITION OPEN UNTIL SET POINT IS ATTAINED, AT WHICH POINT IT SHALL MAINTAIN POSITION. IF THE HEATING DEMAND DECREASES, THE MODULATING VALVE (V-3 OR V-4) SHALL POSITION AS REQUIRED TO MAINTAIN SET POINT. IF THE HEATING DEMAND DECREASES TO THE POINT THAT (V-3 OR V-4) ATTAINS THE CLOSED POSITION, VALVE (V-5 OR V-6) SHALL SLOWLY CLOSE WITH SET POINT MAINTAINED BY VERNIER VALVE (V-3 OR V-4).

### HOT WATER HEATING SET POINT CONTROL

AFTER THE LEAD PUMP VSMC HAS RESET TO ITS MINIMUM SPEED, THE HOT WATER HEATING SUPPLY SETPOINT SHALL BE VARIED INVERSELY WITH OUTSIDE TEMPERATURE (SEE RESET SCHEDULE) OR BE MAINTAINED AT THE MINIMUM TEMPERATURE THAT WILL SATISFY THE HEATING DEMANDS OF REHEAT ZONES (MONITORED THROUGH THE "ECC" VIA THE DCP).

NOTE: IN THE EVENT OF A DIGITAL CONTROL FAILURE, THE BUILDING HOT WATER SYSTEM CAN BE OPERATED SEMI-AUTOMATICALLY THROUGH ENABLING THE "EMERGENCY DCP BYPASS" SWITCH AND ANALOG BACK-UP CONTROLS LOCATED AT THE HEATING HOT WATER SYSTEM DCP. WHEN THIS BACK-UP MODE IS ENABLED; THE HEATING HOT WATER PUMPS AND CONVERTER SYSTEMS CAN BE ENABLED MANUALLY BY THE FACILITY ENGINEER THROUGH SWITCHES AT THE DCP. HARD WIRED CONTROLLERS SHALL CONTROL BUILDING DIFFERENTIAL PRESSURE VIA THE HOT WATER PUMP "VSMC'S" AND REGULATE THE CONVERTER CONTROL VALVES IN A SEQUENTIAL MANNER.



Western Team Director

Approved Project Director

### ARCHITECT

The Ratcliff Architects  
5856 Doyle Street  
Emeryville, CA 94608

P.O. Box 1022  
Berkeley, CA 94701  
(510) 852-1972

### ASSOCIATE ARCHITECT

Stone, Marracini and Patterson  
One Market Plaza  
Spear Street Tower, Suite 400  
San Francisco, CA 94105  
(415) 227-0100

### CONSULTANTS

Structural Engineers  
H.J. Degenkolb Associates

Mechanical Engineers  
Capital Engineering Consultants, Inc.

Electrical Engineers  
The Engineering Enterprise

Cost Estimator  
Adamson Associates

Landscape Design/  
Land Planning  
Omni Lang Associates, Inc.

Civil Engineer  
Sandis and Associates, Inc.

Elevator Consultant  
Syske and Hennessy

Fire Protection  
Rolf Jensen and Associates

Food Service Consultant  
Cini-Little International, Inc.



Capital Engineering Consultants, Inc.  
Sacramento, California  
311115  
DESIGNER/DRAWER PROJECT NO.

RECORD DRAWINGS 8-14-98

Revisions Date

Location VA Medical Center  
Palo Alto, CA

Project Title  
REPLACE CLINICAL/  
BED TOWER FOR  
SEISMIC CORRECTIONS

FULLY SPRINKLERED

TRA Project No. 93007 Checked TGJ Drawn DA

Drawing Title  
CONTROL DIAGRAM &  
SEQUENCE OF  
OPERATION -  
HEATING WATER SYSTEM

Scale NONE

VA Project No. 640-042G

Building Number 100

Date 14 AUG 1998

DRAWING NO. H5.4.1

Dwg of